

GENERAL SYSTEM NOTES

- 1) FIRE ALARM SYSTEM IS POWER LIMITED. METALLIC RACEWAY SHALL BE USED IF REQUIRED BY CODE, SPECIFICATIONS AND CONTRACT DOCUMENTS OR AHA.
- 2) ALL RACEWAYS MUST BE FREE OF MOISTURE.
- 3) REFER TO SIMPLEX FIRE ALARM DATASHEETS FOR PROPER TYPE AND SIZES OF REQUIRED DEVICE MOUNTING ELECTRICAL BOXES. ELECTRICAL CONTRACTOR IS RESPONSIBLE FOR PROPER INSTALLATION OF ALL DEVICES.
- 4) AC VOLTAGE IS NOT PERMITTED IN THE SAME RACEWAY AS FIRE ALARM WIRING.
- 5) UNRELATED (NON-FIRE ALARM) WIRING SHALL NOT BE IN THE SAME RACEWAY AS FIRE ALARM WIRING.
- 6) ALL CONTRACTOR FIELD WIRING MUST ENTER TOP RIGHT AND/OR BOTTOM RIGHT OF FIRE ALARM CONTROL PANEL ONLY.
- 7) ZONE CIRCUITS AND SIGNAL CIRCUITS ARE ELECTRICALLY SUPERVISED. BRANCH CIRCUITS SHALL BE LOOPED TO MAINTAIN INTEGRITY OF SUPERVISED CIRCUITS--TAPPING OF ZONE CIRCUITS AND SIGNAL CIRCUITS IS NOT PERMITTED.
- 8) REFER TO FACP MODULE DIAGRAMS, INCLUDED WITH FACP, FOR SPECIFICATIONS AND INFORMATION ON INDIVIDUAL PANEL MODULES. VERIFY ALL CONNECTIONS WITH A SIMPLEX FIELD TECHNICAL REPRESENTATIVE PRIOR TO TERMINATION.
- 9) ALL FIRE ALARM WIRING SHALL TEST FREE OF OPENS, SHORTS AND GROUNDS.
- 10) ALL WIRING SHALL BE LABELED AND TAGGED.
- 11) ELECTRICAL CONTRACTOR IS RESPONSIBLE FOR INSTALLATION AND MAKING ALL FINAL CONNECTIONS PRIOR TO JOB CHECKOUT AND FINAL TESTING BY A SIMPLEX FIELD TECHNICAL REPRESENTATIVE. CALL A MINIMUM OF 5 DAYS IN ADVANCE TO SCHEDULE A SIMPLEX TECHNICIAN AT (425) 827-3700.
- 12) ELECTRICAL CONTRACTOR IS RESPONSIBLE FOR MAKING ALL ARRANGEMENTS FOR INSPECTION, TEST AND CERTIFICATION OF THE FIRE ALARM SYSTEM BY ALL APPROPRIATE AUTHORITIES.
- 13) UPON WRITTEN REQUEST, SIMPLEX WILL PROVIDE WRITTEN INSTRUCTIONS REGARDING THE APPROPRIATE WIRE/CABLE FOR INSTALLATION OF THE EQUIPMENT(S) IDENTIFIED IN THESE DRAWINGS. SIMPLEX SHALL NOT BE RESPONSIBLE FOR PROBLEMS OR DAMAGES RESULTING FROM THE USE OF WIRE/CABLE OTHER THAN THAT WHICH HAS BEEN IDENTIFIED IN WRITING BY SIMPLEX FOR A SPECIFIC APPLICATION.
- 14) ALL WIRING SHALL MEET ALL APPLICABLE NATIONAL ELECTRIC CODE ARTICLES FOR FIRE ALARM AND LOW VOLTAGE WIRING.

ARCHITECT: CORNERSTONE ARCHITECTURAL GROUP, P.S.
SEATTLE, WA

FIRE ALARM SYSTEM DESIGNED BY: SIMPLEX TIME RECORDER CO.
KIRKLAND, WA

FIRE ALARM SYSTEM INSTALLATION BY: SIMPLEX TIME RECORDER CO.
KIRKLAND, WA


*EQUIPMENT FOR FIRE ALARM SYSTEM BY: SIMPLEX TIME RECORDER CO.
KIRKLAND, WA

WASHINGTON STATE CONTRACTORS #SIMPLT051M6

* THESE DRAWINGS DO NOT SUPERSEDE THE CONTRACT DRAWINGS AND SPECIFICATIONS. THEY ARE INTENDED AS A SUPPLEMENT ONLY AND MUST BE USED IN CONJUNCTION WITH THE CONTRACT DOCUMENTS. THEY DO NOT MODIFY THE CONTRACTORS OBLIGATIONS TO CONFORM TO THE PROJECTS ORIGINAL DESIGN CRITERIA.

© 2000 Simplex Time Recorder Co.
Gardner, MA 01441

ADDRESSABLE DETECTOR IDENTIFICATION

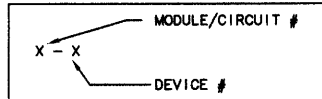

WIRE CODE

ALL WIRING TO MEET CURRENT NATIONAL ELECTRIC CODE ARTICLE 760, 300, 310, 370, 725 AND ALL RELATED SECTION CODE REQUIREMENTS

LETTER	QTY	COLOR/TYPE	SIZE	FUNCTION
A	2	BLACK/ORANGE TFN	18	ZONE
C	2	RED/BLUE THHN	12	STROBE
D	4	(2)RED/(2)BLUE THHN	12	STROBE LOOP
H	1	WEST PENN D975	18	SERIAL ANNUNCIATOR
J	2	RED/BLACK THHN	14	
J	1	TWISTED SHIELD PAIR	14	SPEAKER CABLE
K	2	TWISTED SHIELD PAIR	14	SPEAKER CABLE LOOP
N	1	WEST PENN D975	18	NETWORK CABLE
P	2	RED/BLACK THHN	14	24VDC POWER
R	2	BLUE/WHITE TFN	18	REMOTE LED W/TEST SW.
R	2	PINK TFN	18	
X	1	WEST PENN D975	18	ADDR. MAPNET DATA LINE

NOTES:

- 1) TAG AND IDENTIFY ALL ZONE WIRES WITH ZONE NUMBER.
- 2) TAG AND IDENTIFY ALL SIGNAL CIRCUIT WIRES WITH SIGNAL CIRCUIT NUMBER.
- 3) TAG AND IDENTIFY ALL ANNUNCIATOR WIRES.

NOTE:

SPEAKER/HORN TO BE TAPPED AT 7.5W

ELECTRICAL CONTRACTOR

- ELECTRICAL CONTRACTOR IS TO SCHEDULE A PRELIMINARY SITE MEETING WITH A SIMPLEX TECHNICAL REPRESENTATIVE. THESE MEETINGS ARE FOR REVIEWING EQUIPMENT LISTS, INSTALLATION PROCEDURES, AND PROVIDING ANSWERS TO QUESTIONS RELATIVE TO SYSTEM INSTALLATION.

- PLEASE ALLOW A MINIMUM OF FIVE WORKING DAYS ADVANCE NOTICE TO SCHEDULE A PRELIMINARY JOB SITE MEETING.

- TO SCHEDULE A MEETING PLEASE CONTACT OUR SERVICE DEPARTMENT AT (425) 827-3700.

NOTES:

- FIRE ALARM DRAWINGS ARE SCHEMATIC ONLY.
- ALL CABLE SUBSTITUTIONS MUST BE APPROVED BY SIMPLEX ENGINEERING IN WRITING.
- NOTE: MOUNT HORN/STROBES, SPEAKER/STROBES AND STROBES AT 80" TO BOTTOM OF DEVICE.
- NOTE: MOUNT PULL STATIONS AT 48" TO TOP OF DEVICE.
- ALL SHIELDS ON THE SAME MAPNET CHANNEL SHALL BE TAPED TOGETHER AND BE FREE OF OPENS, SHORTS, AND GROUNDS.
- DO NOT EXCEED 2500 FT OUT TO FURTHEST DEVICE-- MAXIMUM 10,000 FT ON MAPNET CHANNEL.
- DRY CONTACT ONLY PROVIDED FOR DOOR HOLDERS, ROLL DOORS AND SMOKE/FIRE DAMPERS - POWER BY OTHERS.

SEQUENCE OF OPERATION	MANUAL PULL STATION	SMOKE DETECTION	HEAT DETECTION	FLOW SWITCH	TAMPER SWITCH	SYSTEM TROUBLE	EXISTING BULK INTERIOR
ACTIVATION OF LOCAL ALARM AT FACP (LED DISP. & AUDIBLE INDICATION)	X	X	X	X	X	X	X
DISPLAY ALARM AT ANNUNCIATOR	X	X	X	X	X	X	X
ACTIVATE ALL AUDIBLE/VISIBLE DEVICES	X	X	X	X	X	X	X
TRANSMIT ALARM SIGNAL TO CENTRAL STATION MONITOR	X	X	X	X	X	X	X
TROUBLE/SUPV. INDICATION AT FACP					X	X	
TROUBLE/SUPV. INDICATION AT ANNUNCIATOR					X	X	
TRANSMIT TROUBLE/SUPV. SIGNAL TO CENTRAL STATION MONITOR					X	X	
OPEN STAIRWELL DOORS (C.A.D. IN LINE)	X	X	X	X	X	X	X

LEGEND

SYMBOL	DESCRIPTION	MODEL #	BACK BOX
	MANUAL PULL STATION	2098-9795 W/	2-GANG DEEP BY EC
	EXISTING MANUAL PULL STATION	2098-9795 W/	2-GANG DEEP BY EC
	SPEAKER HORN	2902-9701	SURFACE MOUNTED
	SPEAKER/STROBE 15/75cd	4903-9326	4" SQ W/1.5" EXT BY EC
	SPEAKER/STROBE 30cd	4903-9329	4" SQ W/1.5" EXT BY EC
	SPEAKER/STROBE 110cd	4903-9332	4" SQ W/1.5" EXT BY EC
	CEILING SPEAKER	4902-9707	4" SQ W/1.5" EXT BY EC
	STROBE 15cd	4904-9331	4" SQ BY EC
	STROBE 15cd	4904-9332	4" SQ BY EC
	STROBE 15cd	4904-9333	4" SQ BY EC
	WEATHERPROOF STROBE	W43T-24-VFR	WBB-R
	10" BELL	4901-9304	WBB-R
	SYNC MODULE	4905-9914	4" SQ BY EC
	PHOTOELECTRIC SMOKE DETECTOR	2098-9201 W/	4" OCT BY EC
	EXISTING SMOKE SENSOR	2098-9201 W/	4" OCT BY EC
	DUCT DETECTOR	4098-9756	SELF-CONTAINED
	HEAT SENSOR	4098-9733 W/	4" OCT BY EC
	EXISTING HEAT SENSOR	4098-9408 W/	4" OCT BY EC
	FIXED-TEMP STAND-ALONE HEAT DETECTOR	2098-9488 W/	4" OCT BY EC
	SUPERVISED IAM	2190-9172	4" SQ DEEP W/COVER BY EC
	DOOR HOLDER	EXISTING	EXISTING
	FLOW SWITCH	BY OTHERS	BY OTHERS
	TAMPER SWITCH	BY OTHERS	BY OTHERS
	POST INDICATOR VALVE	BY OTHERS	BY OTHERS
	SECTION CONTROL VALVE	BY OTHERS	BY OTHERS
	SPRINKLER VALVE DETECTOR	BY OTHERS	BY OTHERS
	'ADT' AUTOMATIC DOOR CONTROL PANEL	BY OTHERS	BY OTHERS
	REMOTE RELAY	2098-9008	SELF-CONTAINED
	GRAPHIC COMMAND CENTER	4190-8101	DESK-TOP
	PRINTER	4190-9007	SELF-CONTAINED
	EXISTING NAC POWER EXTENDER PANEL	4009-9002	16.5" X 13.5" X 4.1875"
	NEW NAC PANEL	4009-9201	16.5" X 13.5" X 4.25"
	LCD ANNUNCIATOR	4803-9101	6-GANG BY EC
	EXISTING FIRE ALARM CONTROL PANEL	4020-8001	36.25" X 25.75" X 4.25"
	MINI-FLEX TRANSPONDER	4100-8019	25.75"W X 36.25"H X 7.75"D
	MAIN 4120 FACP	4100.8210	25.75"W X 36.25"H X 7.75"D

NAC PANEL #1

BATTERY CALCULATIONS - CROSSDOCK NAC #1

DOES THE SYSTEM HAVE AN EMERGENCY GENERATOR THAT MEETS NEC 700.701 ☐ YES ☒ NO?

HOW MANY HOURS OF BATTERY STANDBY ARE REQUIRED?
☐ 4 ☒ 24 ☐ 48 ☐ 60 (4 HRS. MIN. W/EMER. GEN.)


QTY	PART #	DESCRIPTION	STANDBY	TOTAL	ALARM	TOTAL
			CURRENT (A)	CURRENT (A)	CURRENT (A)	ALARM (A)
1	4009-8001	EXISTING NAC #1 PANEL	0.0870	0.0870	0.1030	0.1030
1	4803-8326	15cd SPEAKER/STROBE	0.0000	0.0000	0.0860	0.0860
13	4803-8328	30cd SPEAKER/STROBE	0.0000	0.0000	0.1280	0.1280
	4803-8330	110cd SPEAKER/STROBE	0.0000	0.0000	0.2800	2.8000
Total Standby=			0.0870		Total Alarm=	4.0930
					Time (Hrs.)	
Total Standby Current Required=			0.0870 X	24.0000		1.8080
Total Alarm Current Required=			0.0930 X	0.0833		0.3408
Total=						1.9488
20% Depletion Factor						0.3896
Total Amp/Hour Required						2.3387
Total Amp/Hour Batteries Provided					(1) Set	6.2000

VOLTAGE DROP CALCULATIONS - NAC #1

CIRCUIT DESCRIPTION	CURRENT	DIST (ft)	VOLTAGE DROP
1) CROSS DOCK FACILITY	1.100	380	1.36
2) CROSS DOCK FACILITY	1.320	385	1.57
3) CROSS DOCK FACILITY	0.975	220	0.70
4) CROSS DOCK FACILITY	0.975	495	0.38

MAPNET CIRCUIT DISTRIBUTION

DO NOT EXCEED 2500ft OUT TO FURTHEST DEVICE--MAXIMUM 10,000ft ON MAPNET CHANNEL

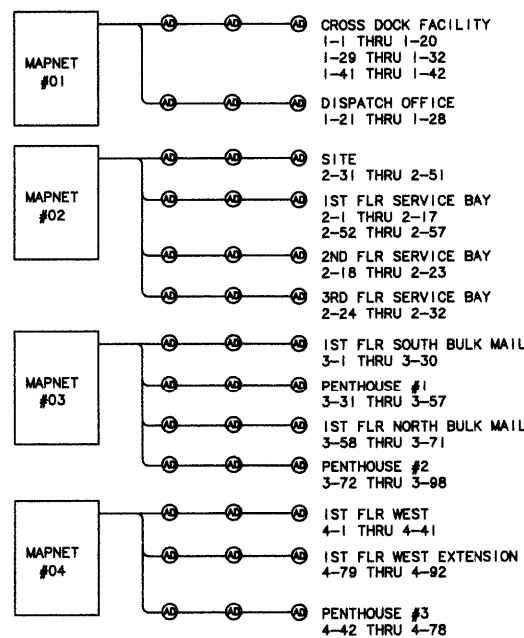

4020 FACP

BATTERY CALCULATIONS

CROSSDOCK 4020 FACP

DOES THE SYSTEM HAVE AN EMERGENCY GENERATOR THAT MEETS NEC 700.701 ☐ YES ☒ NO?

HOW MANY HOURS OF BATTERY STANDBY ARE REQUIRED?
☐ 4 ☒ 24 ☐ 48 ☐ 60 (4 HRS. MIN. W/EMER. GEN.)

QTY	PART #	DESCRIPTION	STANDBY CURRENT (A)	TOTAL STANDBY (A)	ALARM CURRENT (A)	TOTAL ALARM (A)
1	4020-8001	EXISTING 4020 FACP	0.0880	0.0880	0.1700	0.1700
2	4803-8331	15cd QUIESCENT STROBE ONLY	0.0000	0.0000	0.0470	0.0940
1	4803-8328	15cd SPEAKER/STROBE	0.0000	0.0000	0.0860	0.0860
1	4803-8330	110cd SPEAKER/STROBE	0.0000	0.0000	0.2280	0.2280
1	2901-8333	EXISTING 10" RED BELL	0.0000	0.0000	0.1100	0.1100
2	W43T-24-VFR	WP STROBE	0.0000	0.0000	0.0860	0.1720
1	4804-8304	NEW 10" RED BELL	0.0000	0.0000	0.0300	0.0300
Total Standby=			0.0880		Total Alarm=	0.6960
			<u>Time (Hrs.)</u>			
Total Standby Current Required=			0.0880 X	24.0000	14.2800	
Total Alarm Current Required=			0.6960 X	0.0833	0.3245	
Total			14.6045			
20% Depletion Factor			2.9280			
Total Amp/Hour Required			17.5263			
Total Amp/Hour Batteries Provided			(1) Set 33.0000			

VOLTAGE DROP CALCULATIONS - 4020 FACP

CIRCUIT DESCRIPTION	CURRENT	DIST (ft)	VOLTAGE DROP
1) DISPATCH OFFICE	0.409	585	0.75
2) OUTSIDE HORN/STROBES	0.316	590	0.61
3) NAC PANEL	.	.	.
4) SPARE	.	.	.

tyco Fire & Security

SimplexGrinnell
KIRKLAND, WA 98033

FIRE ALARM SYSTEM COVER SHEET

USPS BULK MAIL/CROSS DOCK/DISPATCH OFFICE

34301 NINTH AVE. SOUTH
FEDERAL WAY, WA.

ISSUE RECORD

REVISION	DATE	DRAWN BY
1	8-10-01	SAL

DRAWN BY: M.C.B.

DATE: 10-22-97

APPROVED BY: N.Y.F.

SIMPLEX PROJECT NUMBER 458-910019-11

SHEET TITLE: FA-COV-02

SHEET NUMBER:

FA-COV-02

FA-COVERS

NAC PANEL #0

BATTERY CALCULATIONS - NAC #0

DOES THE SYSTEM HAVE AN EMERGENCY GENERATOR THAT MEETS NEC 700.701 ☐ YES ☐ NO?

HOW MANY HOURS OF BATTERY STANDBY ARE REQUIRED?
☐ 4 ☐ 24 ☐ 48 ☐ 60 (4 HRS. MIN. W/EMER. GEN.)

QTY	PART #	DESCRIPTION	STANDBY CURRENT (A)	TOTAL STANDBY (A)	ALARM CURRENT (A)	TOTAL ALARM (A)
1	4008-8801	NEW NAC #0 PANEL	0.0870	0.0870	0.1030	0.1030
33	4804-8333	110vdc GUICALENT STROBE ONLY	0.0000	0.0000	0.1910	4.3830
3	4803-8338	15w SPEAKER/STROBE	0.0000	0.0000	0.0980	0.2980
1	4803-8338	30w SPEAKER/STROBE	0.0000	0.0000	0.1980	0.1980
Total Standby=			0.0870			4.9080
			Time (Hrs.)			
Total Standby Current Required=			0.0870	X	24.0000	1.6080
Total Alarm Current Required=			4.9080	X	0.0833	0.4087
Total=						2.0167
20% Depletion Factor						0.4033
Total Amp/Hour Required						2.4200
Total Amp/Hour Batteries Provided				(1) Set		10.0000

VOLTAGE DROP CALCULATIONS - NAC #0

110vdc	15w	30w	CIRCUIT DESCRIPTION	CURRENT	DIST (ft)	VOLTAGE DROP
☒	☒	☒				
7	0	0	N6-1) BULK MAIL - 1ST FLOOR	1.337	365	1.59
8	0	0	N6-2) BULK MAIL - 1ST FLOOR	1.528	420	2.09
4	0	1	N6-3) BULK MAIL - 1ST FLOOR	0.889	350	1.01
4	3	0	N6-4) BULK MAIL - 1ST FLOOR	1.049	475	1.62

NAC PANEL #8

BATTERY CALCULATIONS - NAC #8

DOES THE SYSTEM HAVE AN EMERGENCY GENERATOR THAT MEETS NEC 700.701 ☐ YES ☐ NO?

HOW MANY HOURS OF BATTERY STANDBY ARE REQUIRED?
☐ 4 ☐ 24 ☐ 48 ☐ 60 (4 HRS. MIN. W/EMER. GEN.)

QTY	PART #	DESCRIPTION	STANDBY CURRENT (A)	TOTAL STANDBY (A)	ALARM CURRENT (A)	TOTAL ALARM (A)
1	4008-8801	NEW NAC #8 PANEL	0.0870	0.0870	0.1030	0.1030
11	4804-8333	110vdc GUICALENT STROBE ONLY	0.0000	0.0000	0.1910	2.1010
4	4803-8338	15w SPEAKER/STROBE	0.0000	0.0000	0.0980	0.3960
1	4801-8304	10" RED BELL	0.0000	0.0000	0.0360	0.0360
1	WAST-24-FR	WEATHERPROOF STROBE	0.0000	0.0000	0.0880	0.0880
Total Standby=			0.0870			2.7020
			Time (Hrs.)			
Total Standby Current Required=			0.0870	X	24.0000	1.6080
Total Alarm Current Required=			2.7020	X	0.0833	0.2251
Total=						1.8331
20% Depletion Factor						0.3666
Total Amp/Hour Required						2.1997
Total Amp/Hour Batteries Provided				(1) Set		10.0000

VOLTAGE DROP CALCULATIONS - NAC #8

110vdc	15w	30w	CIRCUIT DESCRIPTION	CURRENT	DIST (ft)	VOLTAGE DROP
☒	☒	☒				
8	0	0	N8-1) BULK MAIL - 1ST FLOOR	1.528	620	3.09
3	2	0	N8-2) BULK MAIL - 1ST FLOOR	0.763	655	1.63
0	2	1	N8-3) BULK MAIL - OUTSIDE	0.308	595	0.60
.	.	.	N8-4) SPARE	.	.	.

NAC PANEL #7

BATTERY CALCULATIONS - NAC #7

DOES THE SYSTEM HAVE AN EMERGENCY GENERATOR THAT MEETS NEC 700.701 ☐ YES ☐ NO?

HOW MANY HOURS OF BATTERY STANDBY ARE REQUIRED?
☐ 4 ☐ 24 ☐ 48 ☐ 60 (4 HRS. MIN. W/EMER. GEN.)

QTY	PART #	DESCRIPTION	STANDBY CURRENT (A)	TOTAL STANDBY (A)	ALARM CURRENT (A)	TOTAL ALARM (A)
1	4008-8801	NEW NAC #7 PANEL	0.0870	0.0870	0.1030	0.1030
18	4804-8333	110vdc GUICALENT STROBE ONLY	0.0000	0.0000	0.1910	2.6680
2	4803-8338	15w SPEAKER/STROBE	0.0000	0.0000	0.0980	0.1980
Total Standby=			0.0870			3.9220
			Time (Hrs.)			
Total Standby Current Required=			0.0870	X	24.0000	1.6080
Total Alarm Current Required=			3.9220	X	0.0833	0.3287
Total=						1.9367
20% Depletion Factor						0.3888
Total Amp/Hour Required						2.3255
Total Amp/Hour Batteries Provided				(1) Set		10.0000

VOLTAGE DROP CALCULATIONS - NAC #7

110vdc	15w	30w	CIRCUIT DESCRIPTION	CURRENT	DIST (ft)	VOLTAGE DROP
☒	☒	☒				
8	0	0	N7-1) BULK MAIL - 1ST FLOOR	1.528	385	1.92
8	0	0	N7-2) BULK MAIL - 1ST FLOOR	1.528	415	2.07
3	2	0	N7-3) BULK MAIL - 1ST FLOOR	0.763	765	1.90
.	.	.	N7-4) SPARE	.	.	.

tyco Fire & Security
SimplexGrinnell

SimplexGrinnell
10830 NORTHEAST 38TH PLACE SUITE 76
KIRKLAND, WA 98033
FAX: 206.835.8222

FIRE ALARM SYSTEM
COVER SHEET

USPS BULK MAIL/CROSS DOCK/DISPATCH OFFICE

34301 110TH AVE. SOUTH
FEDERAL WAY, WA.

ISSUE RECORD

PURPOSE	DATE	DRAFTER
REVISION	5/28/00	BAL
ASBUILT	8-10-01	BAL


DRAWN BY: M.C.B.	REVISION INFORMATION
DATE: 10-22-97	9/1/00
APPROVED BY: N.Y.F.	APPROVED BY: K.C.

SIMPLEX PROJECT NUMBER
458-910019-11

SHEET TITLE:
FA-COV-04

SHEET NUMBER:

FA-COV-04

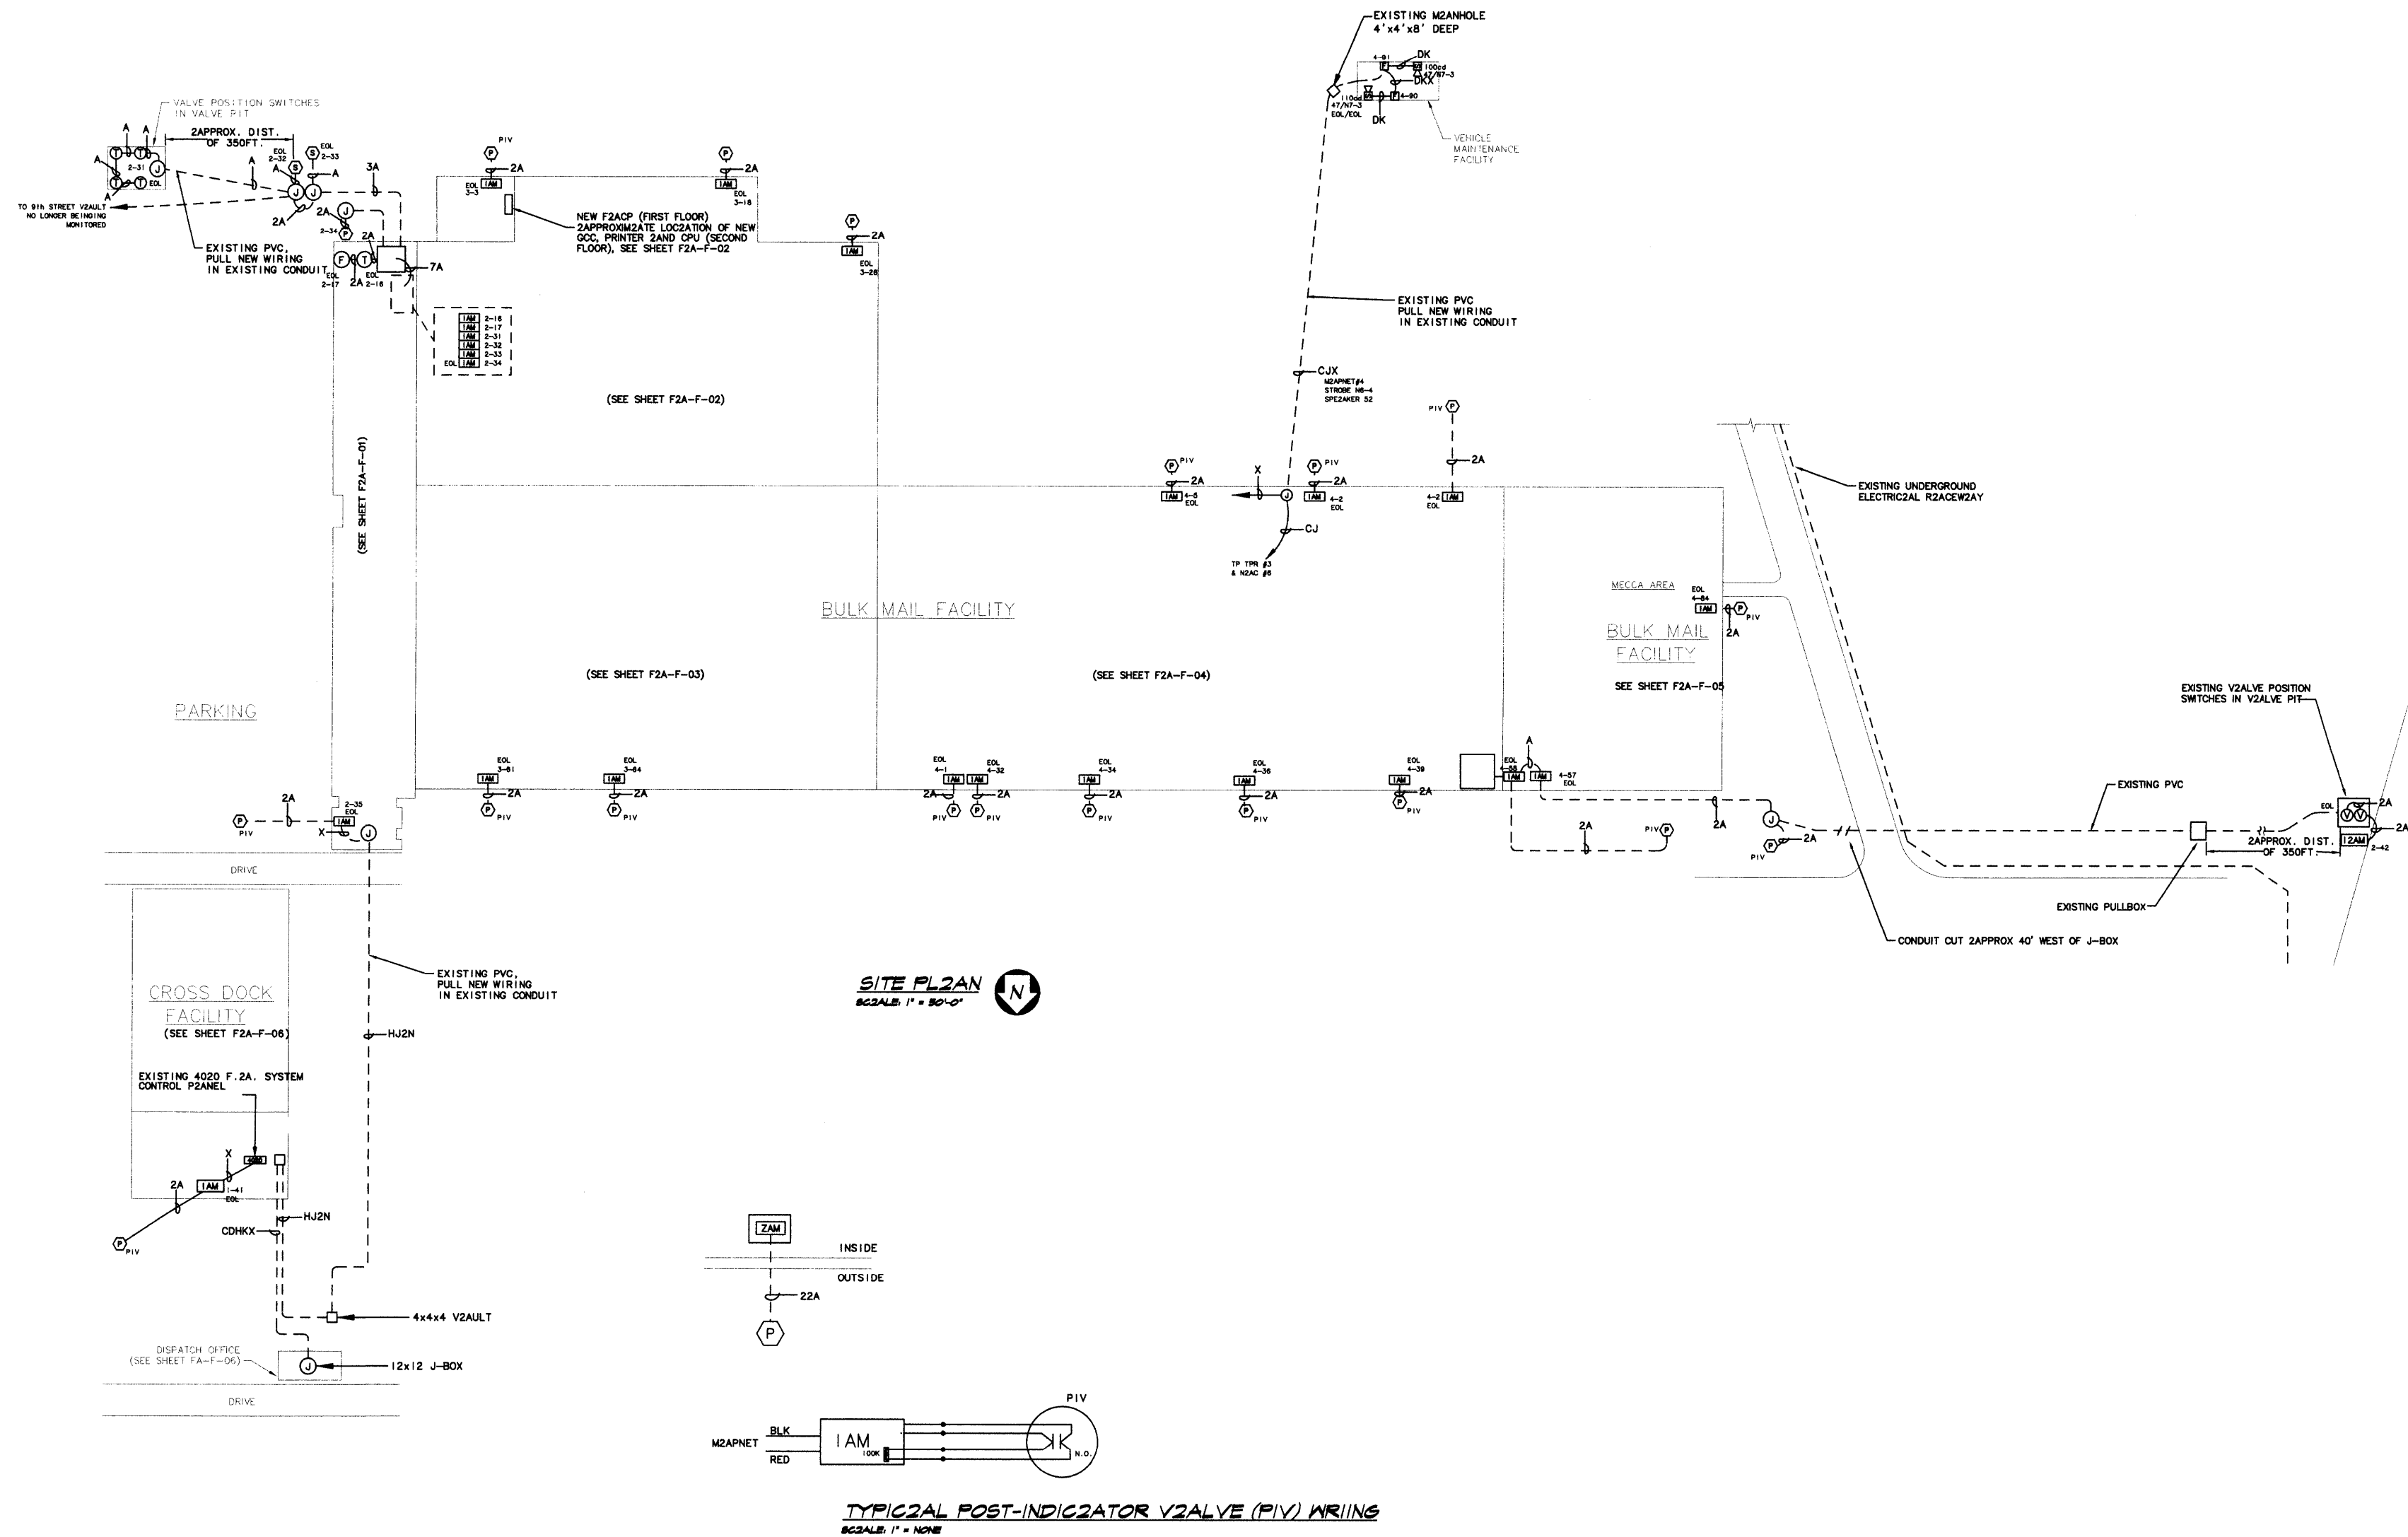

tyco Fire & Security
SimplexGrinnell
 10690 NORTHEAST 38TH PLACE SUITE 76
 KIRKLAND, WA 98033
 TEL: 206.835.5555
 FAX: 206.835.5556

FIRE ALARM SYSTEM
SITE PLAN
USPS BULK MAIL/CROSS DOCK/DISPATCH OFFICE
 34301 NINTH AVE. SOUTH
 FEDERAL WAY, WA

ISSUE RECORD

REVISION	DATE	REVISION
1	8/28/00	SAL
2	8-10-01	SAL

DRAWN BY:
M.C.B.

REVISION INFORMATION

DATE:
10-22-97

APPROVED BY:
N.Y.F.





APPROVED BY:
K.C.

SIMPLEX PROJECT NUMBER
458-910019-11

SHEET TITLE:
FA-SITE-01

SHEET NUMBER:
FA-SITE-01

FA-SITE-01

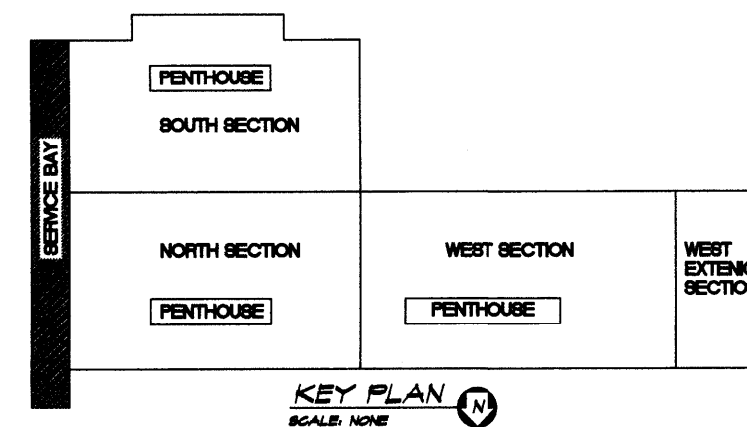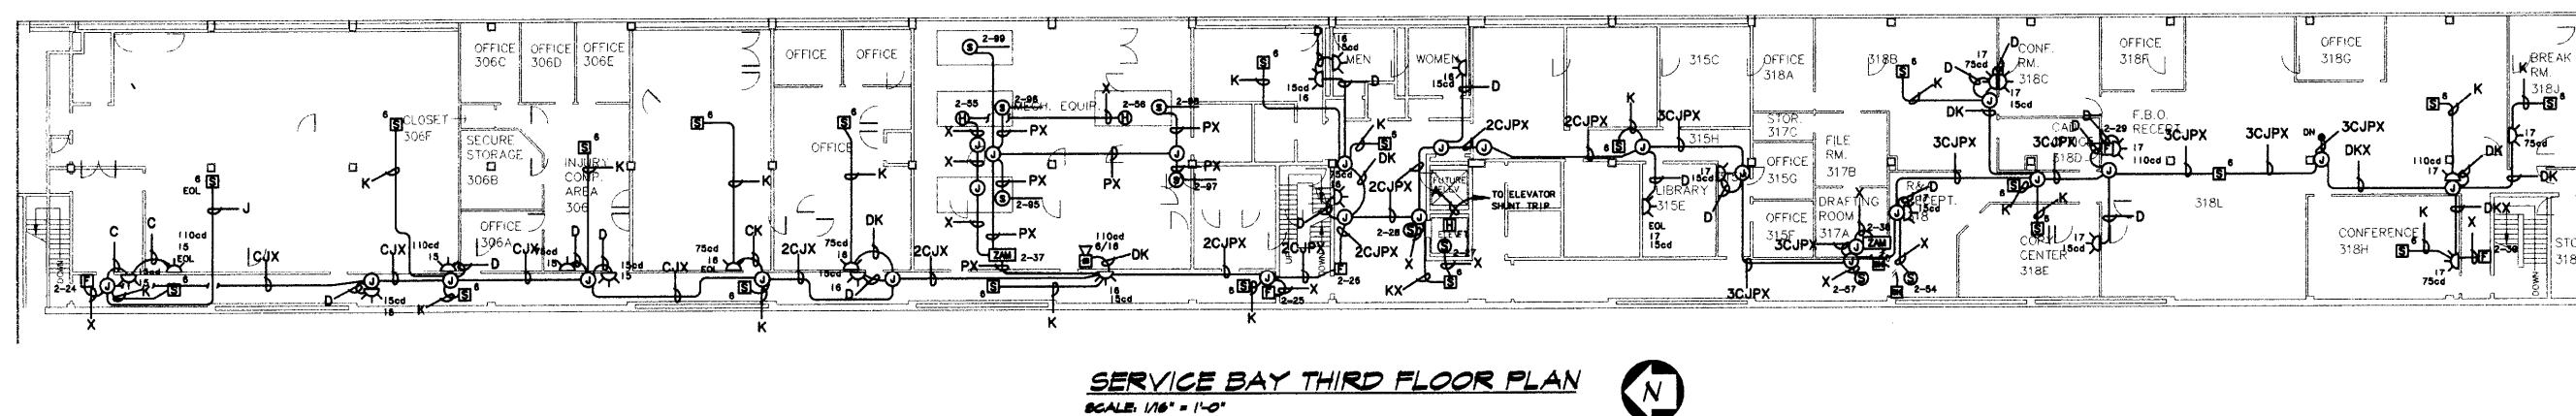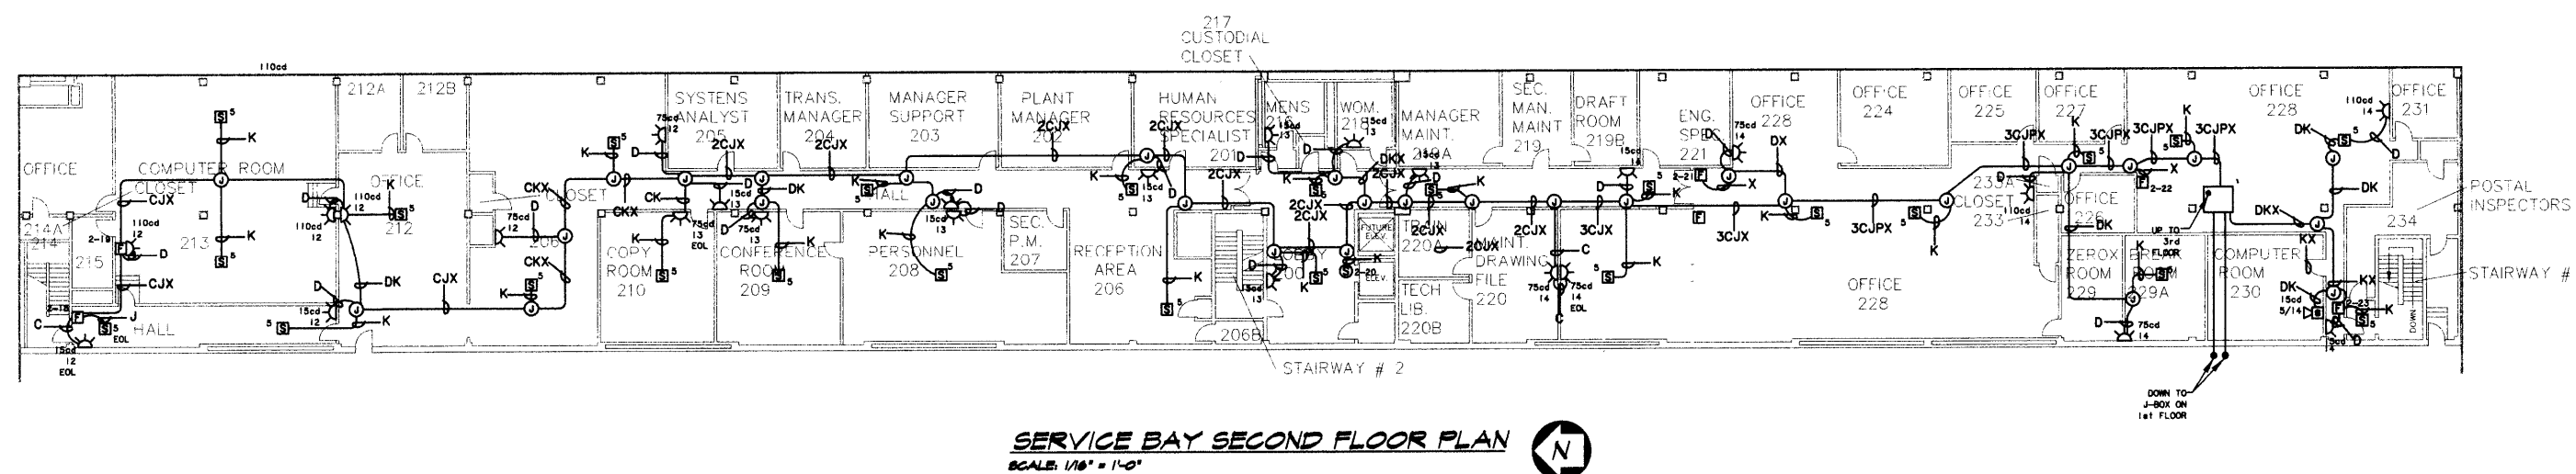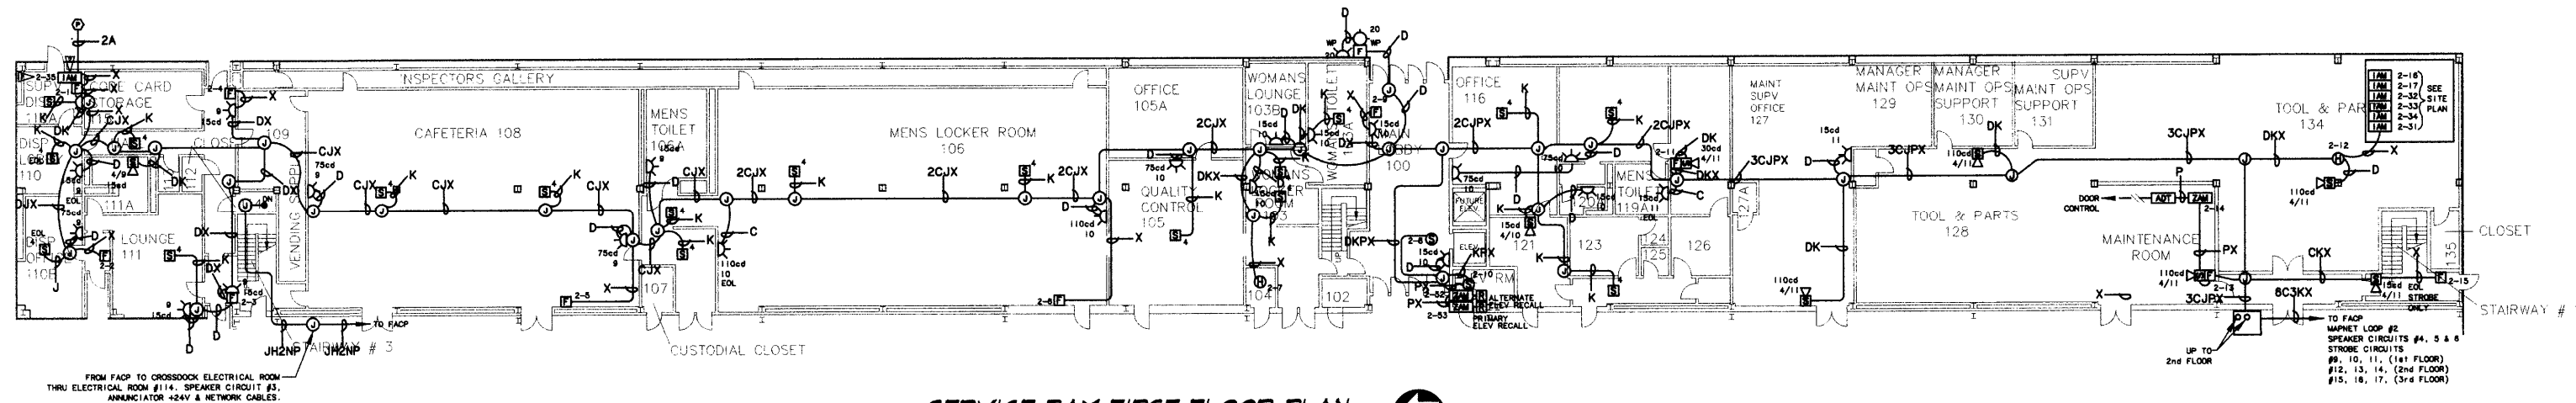

tyco Fire & Security **SimplexGrinnell**

SimplexGrinnell
10630 NORTHEAST 38TH PLACE SUITE 75
KIRKLAND, WA 98033

FIRE ALARM SYSTEM
SERVICE BAY (1ST, 2ND & 3RD FLOORS)
USPS BULK MAIL/CROSS DOCK/DISPATCH OFFICE
34301 NINTH AVE. SOUTH
FEDERAL WAY, WA.

ISSUE RECORD

PURPOSE	DATE	DRAWN
REVISION	8/26/00	SAL
ASSEMBLY	8-10-01	SAL

DRAWN BY:
M.C.B.

DATE:
10-22-97

APPROVED BY:
N.Y.F.

REVISION INFORMATION
9/1/00
K.C.

SIMPLEX PROJECT NUMBER
458-910019-11


SHEET TITLE:
FA-F-01

SHEET NUMBER:
FA-F-01



SHEET NUMBER:
FA-E-02

FA--1ST--FLOOR

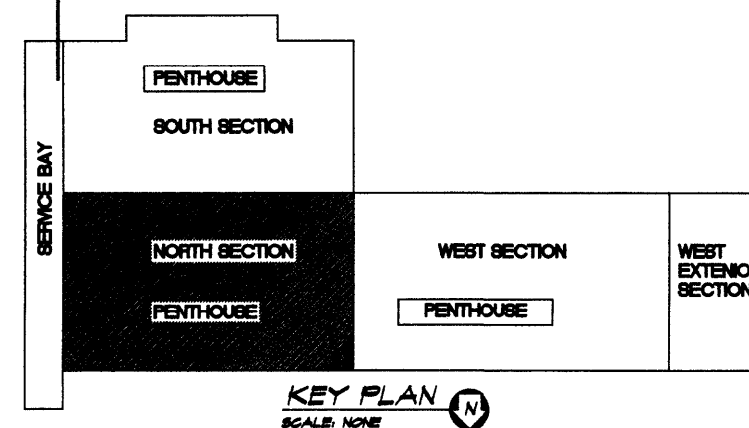

FIRE ALARM SYSTEM
1ST FLOOR NORTH & PENTHOUSE #2 NORTH FLOOR PLANS
USPS BULK MAIL/CROSS DOCK/DISPATCH OFFICE

ISSUE RECORD		
PURPOSE	DATE	DRAFTER
 REVISION	8/28/00	SAL
ASSEMBLY	8-10-01	SAL



DRAWN BY: M.C.B.	REVISION INFORMATION
DATE: 10-22-97	
APPROVED BY: N.Y.F.	APPROVED BY: K.C.

SIMPLEX PROJECT NUMBER
458-910019-11

SHEET TITLE:
FA-F-03

SHEET NUMBER:

FA-F-03

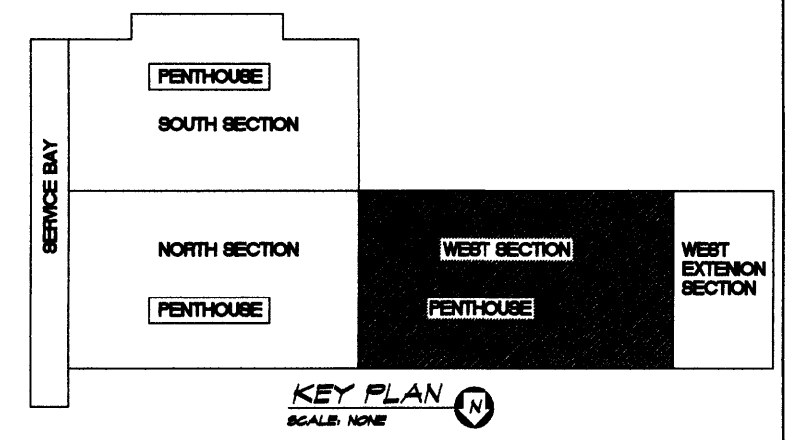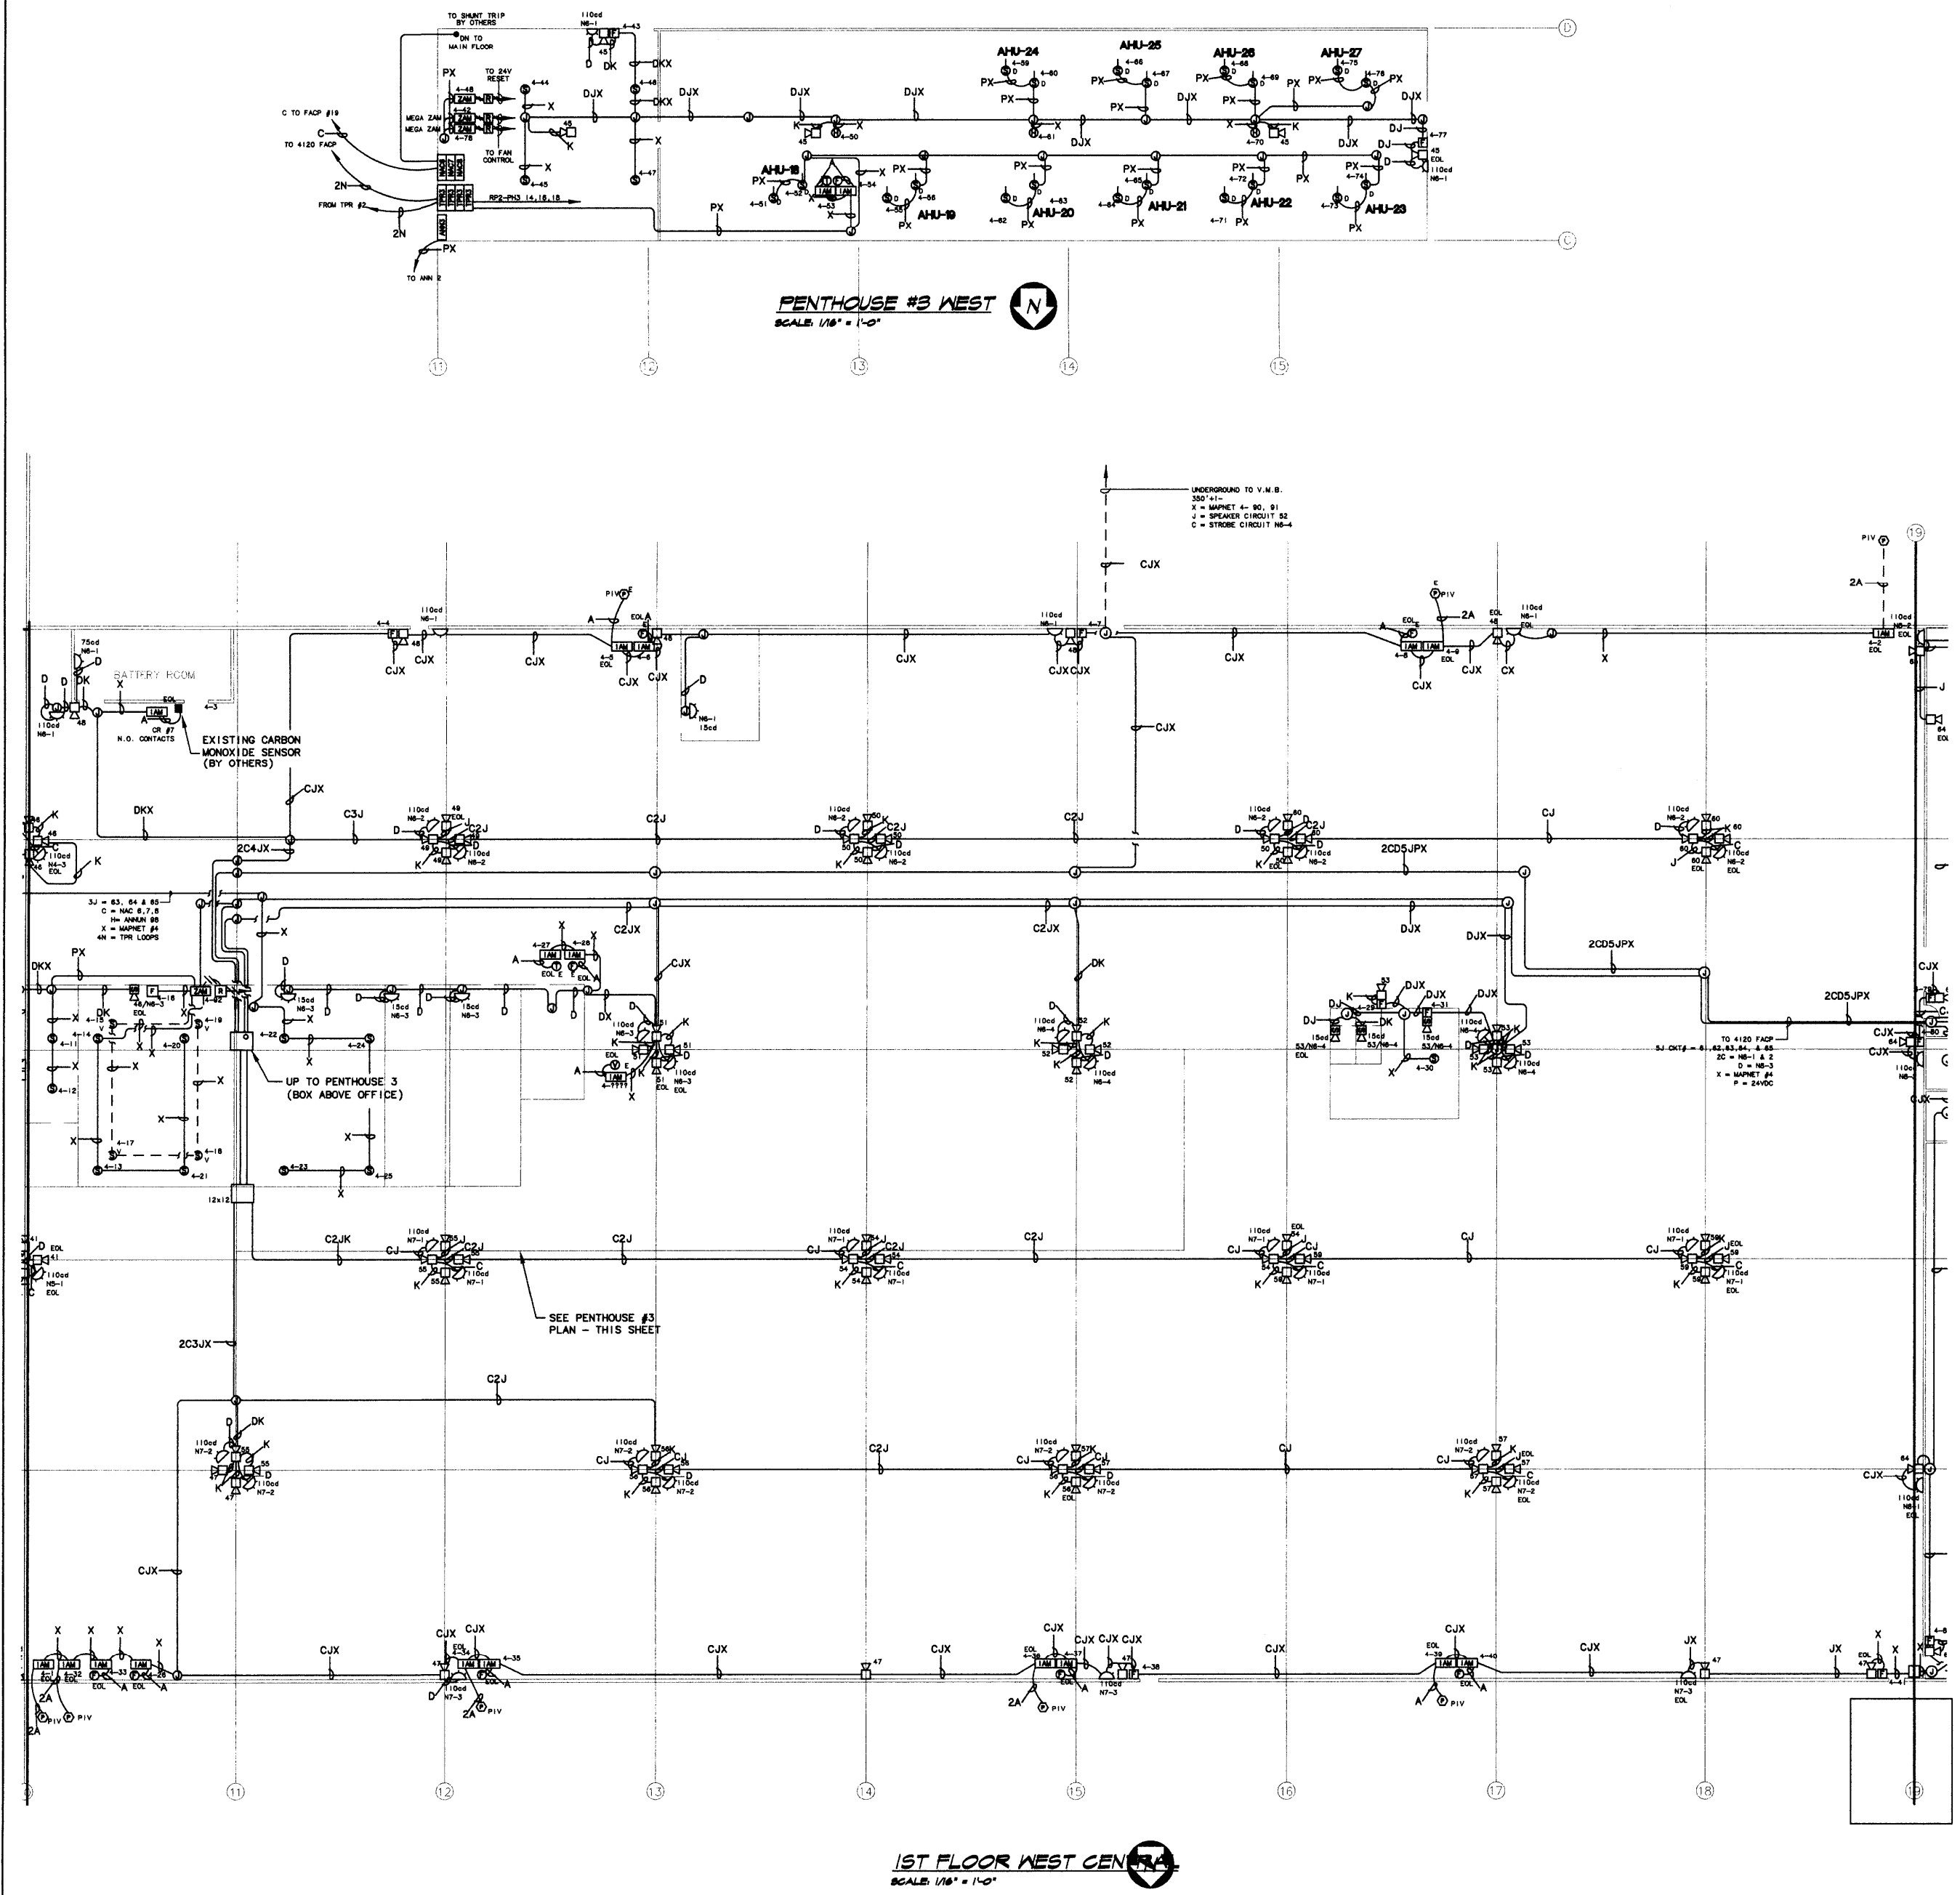

tyco Fire & Security
SimplexGrinnell
 10850 NORTHEAST 38TH PLACE SUITE 76
 KIRKLAND, WA 98033
 (206) 835-8888
 FAX (206) 835-8889


FIRE ALARM SYSTEM
1ST FLOOR WESTCENTRAL - PENTHOUSE #3 WEST FLOOR PLANS
USPS BULK MAIL/CROSS DOCK/DISPATCH OFFICE
 34301 NINTH AVE. SOUTH
 FEDERAL WAY, WA.

ISSUE RECORD

REVISION	DATE	DRAWN BY	CHECKED BY
1	6/26/00	BAL	
2	8-10-01	BAL	

DRAWN BY: M.C.B.	REVISION INFORMATION
DATE: 10-22-97	9/1/00
APPROVED BY: N.Y.F.	K.C.
SIMPLEX PROJECT NUMBER 458-910019-11	
SHEET TITLE: FA-F-04	
SHEET NUMBER: FA-F-04	

FA-1ST FLOOR

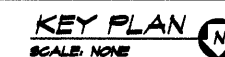


SimplexGrinnell
10630 NORTHEAST 38TH PLACE SUITE 76
KIRKLAND, WA 98033

SALAR: (408) 827-8788
SALES: (408) 827-8788
SERVICES: (408) 827-8788


34301 NINTH AVE. SOUTH
FEDERAL WAY WA

FA-F-05

FA-1ST FLOOR

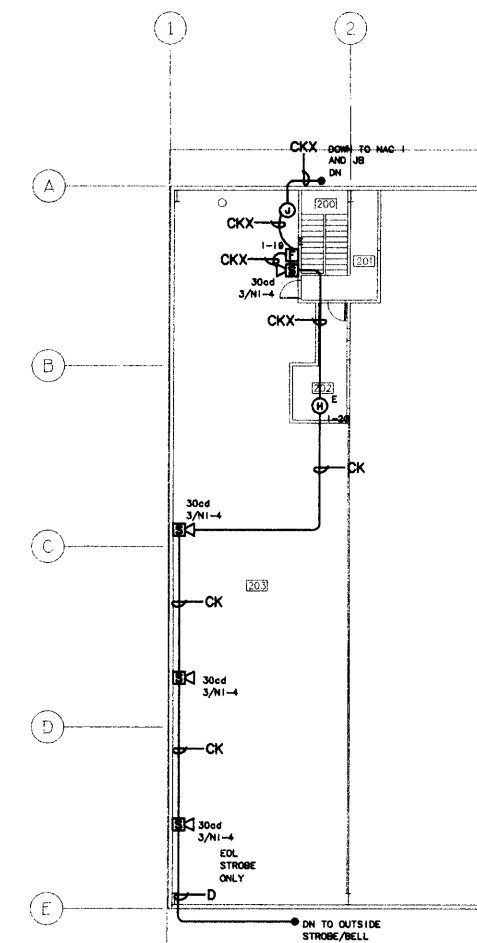

▷ INTERCEPT EXISTING MAPNET CIRCUIT.

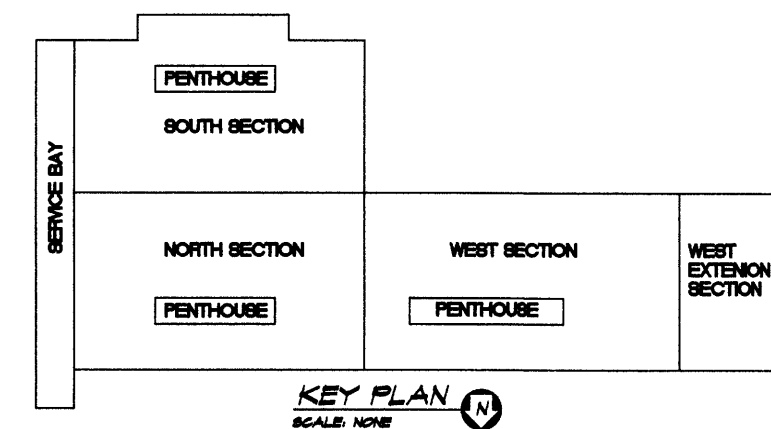

FA-F-06

FA-1ST FLOOR